

June 10, 2013

Ms. Kristine Matzko
Remedial Project Manager (3HS21)
U.S. EPA Region III
1650 Arch Street
Philadelphia, Pennsylvania 19103-2029

**Re: Metal Bank Cottman Avenue NPL Site
Monthly Report due June 10, 2013
Reporting Period: May 1 through May 31, 2013**

Dear Ms. Matzko:

As provided in Paragraph 31 of the Utility Consent Decree, and on behalf of the Cottman Avenue PRP Group, Environ Corporation as the Supervising Contractor is submitting to USEPA three copies of a written monthly progress report. Copies of the monthly progress reports are attached to this letter.

Please contact me (617.946.6115) if you need additional information regarding this submission.

Very truly yours,

ENVIRON International Corporation



Joseph P. Vitale, PE
Project Director

cc: Cottman Avenue PRP Group
Steering and Technical Committees
Dan J. Jordanger, Esquire

Enclosures
3331508

Project Name: Metal Bank NPL Site	For the Month: May 2013	
Project Location: Philadelphia, PA	Report Number: 86	Dated: June 10, 2013

Name: Joseph P. Vitale (ENVIRON)		Title: Project Director
Telephone No.: (617) 946-6115		Telefax No.: (617) 946-3229
Reporting Period: May 1 through May 31, 2013		
(a) Describe the actions, including submittal of work plans and other deliverables, which have been taken toward achieving compliance with the Consent Decree during the previous month:		
Actions or Deliverables		Dates Performed or Submitted
Conducted Vegetation Inspection	May 14th	
Submitted Sheet Pile Wall Inspection Report	May 17th	
(b) List summaries of inspections, sampling, testing, and other data received or generated in the previous month, and when possible, attach the documentation to this report:		
Submittals	Dates Performed	Attached/Separate Cover
Sheet Pile Wall Inspection Report	5/17/2013	Attached to this report
(c) Describe all actions, including, but not limited to, data collection and implementation of work plans, which are scheduled for the next month and provide other information relating to the progress of work:		
The current 2-month look-ahead schedule for LTM and O&M is as follows:		
LTM Activities	Start Date	Anticipated Completion Date
Herbicide Application Plan	June 3 rd	June 14 th
Initial herbicide application	Week of July 8th	Week of July 8th
Follow-up herbicide application	Week of July 24th	Week of July 24 th
Mow site	Week of August 5 th	Week of August 5 th

Project Name: Metal Bank NPL Site	For the Month: May 2013	
Project Location: Philadelphia, PA	Report Number: 86	Dated: June 10, 2013

(d) Include information that may affect the future schedule for implementation of the Work, and a description of efforts made to mitigate those delays or anticipated delays:

As stated in the previous monthly report, we are delaying herbicide application until spring of 2013 following the schedule presented in the Invasive Species Control Plan. We conducted a preliminary inspection of the vegetation on March 21, 2013. This inspection shows the current growth of cover vegetation to be less than 5 inches in length. Greater growth of vegetation is required to properly apply the herbicide. We conducted the invasive species inspection on May 14th and we are scheduled to apply the herbicide in July 2013 to allow sufficient time for greater growth of the vegetative cover.

(e) Include any modifications to the work plans or other schedules that the Utility PRP Group has proposed to EPA or that have been approved by EPA:

- None

(f) Describe all activities undertaken in support of the Community Relations Plan during the previous month and those to be undertaken in the next month:

- None



Walter J. Papp, Jr., Ph.D, P.E.
Senior Partner

Nidal M. AbiSaab, P.E.
Partner

Robert Alperstein, P.E.
Consultant

May 17, 2013

12C1135

Mr. Joseph Vitale, PE, LSP
ENVIRON International
20 Custom House Street
Boston, MA 02110

Re: Report
Sheet Pile Wall Inspection
Metal Bank NPL Site
7301 Milnor Street
Philadelphia, PA 19136

Dear Mr. Vitale:

This report is submitted in accordance with our agreement dated November 12, 2012. It covers our general understanding of the construction and purpose of the sheet pile wall at the referenced site. It also covers a visual structural evaluation of the sheet pile wall, identification of maintenance repairs and development of a monitoring plan.

Project Description

The site is located on the western shore of the Delaware River in an industrialized section of northeastern Philadelphia, Pennsylvania. We understand the site contained PCBs and has been remediated. Part of the remedial plan was to design a sheetpile wall to retain soil from eroding into the Delaware River to the south of the site. We also understand the sheet pile wall has been monitored for tilt and requires a five (5) year visual inspection.

Referenced Documents

- Topographic Survey Final Contour as-built as of January 19, 2010, Metal Bank NPL Site. Drawing No. 09-08711-001 by Rettew Associates, Inc., dated February 23, 2010.
- Memo to Joseph Vitale from Don Dotson of AMEC dated September 5, 2008.
- Sheetpile Wall General Plan & Notes, Drawing No. C-26, Sheet 32 of 49 By AMEC dated September 6, 2002.
- Sheetpile Wall Partial Plan – Zone 1, Drawing No. C-27, Sheet 33 of 49 By AMEC dated September 6, 2002.
- Sheetpile Wall Partial Plan – Zone 2, Drawing No. C-28, Sheet 34 of 49 By AMEC dated September 6, 2002.
- Sheetpile Wall Partial Plan – Zone 3, Drawing No. C-29, Sheet 35 of 49 By AMEC dated September 6, 2002.
- Sheetpile Wall Sections, Drawing No. C-30, Sheet 36 of 49 By AMEC dated September 6, 2002.

The referenced documents are presented in Appendix A.

Observations and Discussions

The undersigned visited the site on November 19, 2012 during high tide and November 27, 2012 during low tide. Both site visits included landside and water side inspection (above the water level) of the sheetpile wall. The waterside inspections were performed with a small watercraft. In general the sheetpile wall appears to be in good condition with some notable areas that changed since the wall was last inspected.

1. Small ruts (runnels) were observed in a few locations immediately behind the sheetpile wall on the landside above the tieback locations as shown on Figure 1. There is no evidence of soil migrating through the sheets at these locations.
2. According to the memorandum prepared by Don Dotson from AMEC dated September 5, 2008, some of the sheet piles were refusing on the underlying weathered schist above the design tip Elev. -40. It was stated that the likely cause of the sheet pile out-of-plumbness was due to the additional energy that was applied in an attempt to reach Elev. -40.
3. The north side of Zone 1 shows movement of the sheetpile wall system. Evidence of movement of the tieback plates relative to the wale was observed by scraping and removal of the epoxy coating on the face of the wale. In addition, the wale and sheetpile wall appear to be bowing with the apex of the bow at the bolted connection. Refer to Figure 2 for location and photographs.
4. Cracks and separation of the wale were observed where the sheetpile wall changes direction (turns east) in Zone 2. The miter cut and joint where the wales meet at the corner was cracked. The cracks appear to be stress (tension) cracks. Refer to Figure 3 for location and photographs. We understand that this area was previously repaired.

5. The west side of Zone 3 shows signs of movement of the sheetpile wall system. Evidence of movement of the tieback plates relative to the wale was observed by scraping and removal of the epoxy coating on the face of the wale. Refer to Figure 4 for location and photographs.

Notably, the sheet pile wall was subjected to Hurricane Sandy in October 2012. It appears that the sheet pile wall performed well and was not damaged during the hurricane.

Conclusions and Recommendations

As discussed earlier, we understand the intent of the sheet pile wall is to retain the soil landside and prevent soil erosion into the Delaware River. We did not check the calculations or perform an independent review of the design. Our conclusions and recommendations are based on our visual observations, experience and judgment.

In general sheetpile walls are relatively flexible and small movements should be expected. The sheet pile wall has shown signs of movement, nevertheless it appears to be performing in accordance with its design intent.

The numbered items below address the observations and discussions listed above.

1. The sheetpile wall sections show the tiebacks were installed through a 10-in diameter PVC sleeve pipe. The ruts may be attributed to:
 - a. Migration of soil into the PVC sleeve.
 - b. Difficulties compacting around the pile during placement of the fill.
 - c. Lateral movement of the sheet (waterside) creating voids or loosening of the soil around the PVC pipe.
 - d. Water flow in and around the PVC pipe.

In our opinion the few small ruts are inconsequential, nevertheless, we recommend filling the ruts to minimize migration of storm water runoff channeling below grade. Local excavations should be made immediately adjacent to the ruts about 1-ft depth below existing site grade. The ruts and local excavation should be filled and compacted in 6-in lifts with “jumping jack” or walk behind vibratory plate compactor until grade is level. The fill soil should comply with the original project specifications. Replace vegetation in kind.

2. Some of sheets were installed out-of-plumb and therefore it is difficult to opine on any subsequent sheetpile movement except for obvious evidence as discussed in items 3, 4, and 5 above.
3. For water side areas where rust or steel is uncoated, prepare all sheets, wales, tieback and apply epoxy sealant in accordance with contract specifications.
4. Corner section of cracked wale: This is likely due to active and at rest soil pressures landside of the sheetpile wall. The resultant forces of these pressures are applied

perpendicular to the plane of the sheetpile wall. Based on visual observations in other areas of the site, the sheetpile wall has moved (translated) laterally. This will tend to separate or “pull” the corner joint of the wale, resulting in cracks of the weld and steel. We recommend repairing the wale by:

- a. Remove epoxy coating and prepare wale to accept steel plate.
- b. Cut and install steel plate as shown on sketch presented in Appendix B.
- c. Areas adjacent to the corner that are cracked shall receive a steel plate placed within the upper wale flange and on top of the bottom wale web.
- d. Apply epoxy sealant in accordance with the original contract specifications.

The repair of the corner wale as discussed in item 4 should be periodically inspected for signs of movement, distress or cracking. If this problem persists a corrective action plan should be submitted for EPA approval.

Three tilt meters have been installed on the sheetpiles to monitor their movement. The tilt monitors have the capacity to measure tilt (rotation) of the sheetpile but not translation.

We recommend installing monitoring points (prisms) on the top of the sheetpile wall to monitor potential movements in the x, y, and z coordinates. Proposed location of the survey monitoring points are presented on Figure 5. The monitoring points should be surveyed once every 6-months and the data reviewed by an experienced engineer. If a trend of wall movement is observed, the frequency of the survey should be increased and the sheetpile wall re-evaluated.

Limitations

This report is based on our interpretation of our understanding of the project, referenced documents provided to us, observations made during the undersigned site visits and our understanding of the project as described above.

We appreciate this opportunity to be of service and look forward to working with you as the project proceeds.

Very truly yours,

RA CONSULTANTS LLC

A handwritten signature in black ink that reads "Walter J. Papp, Jr." The signature is written in a cursive, flowing style.

Walter J. Papp, Jr., P.E.

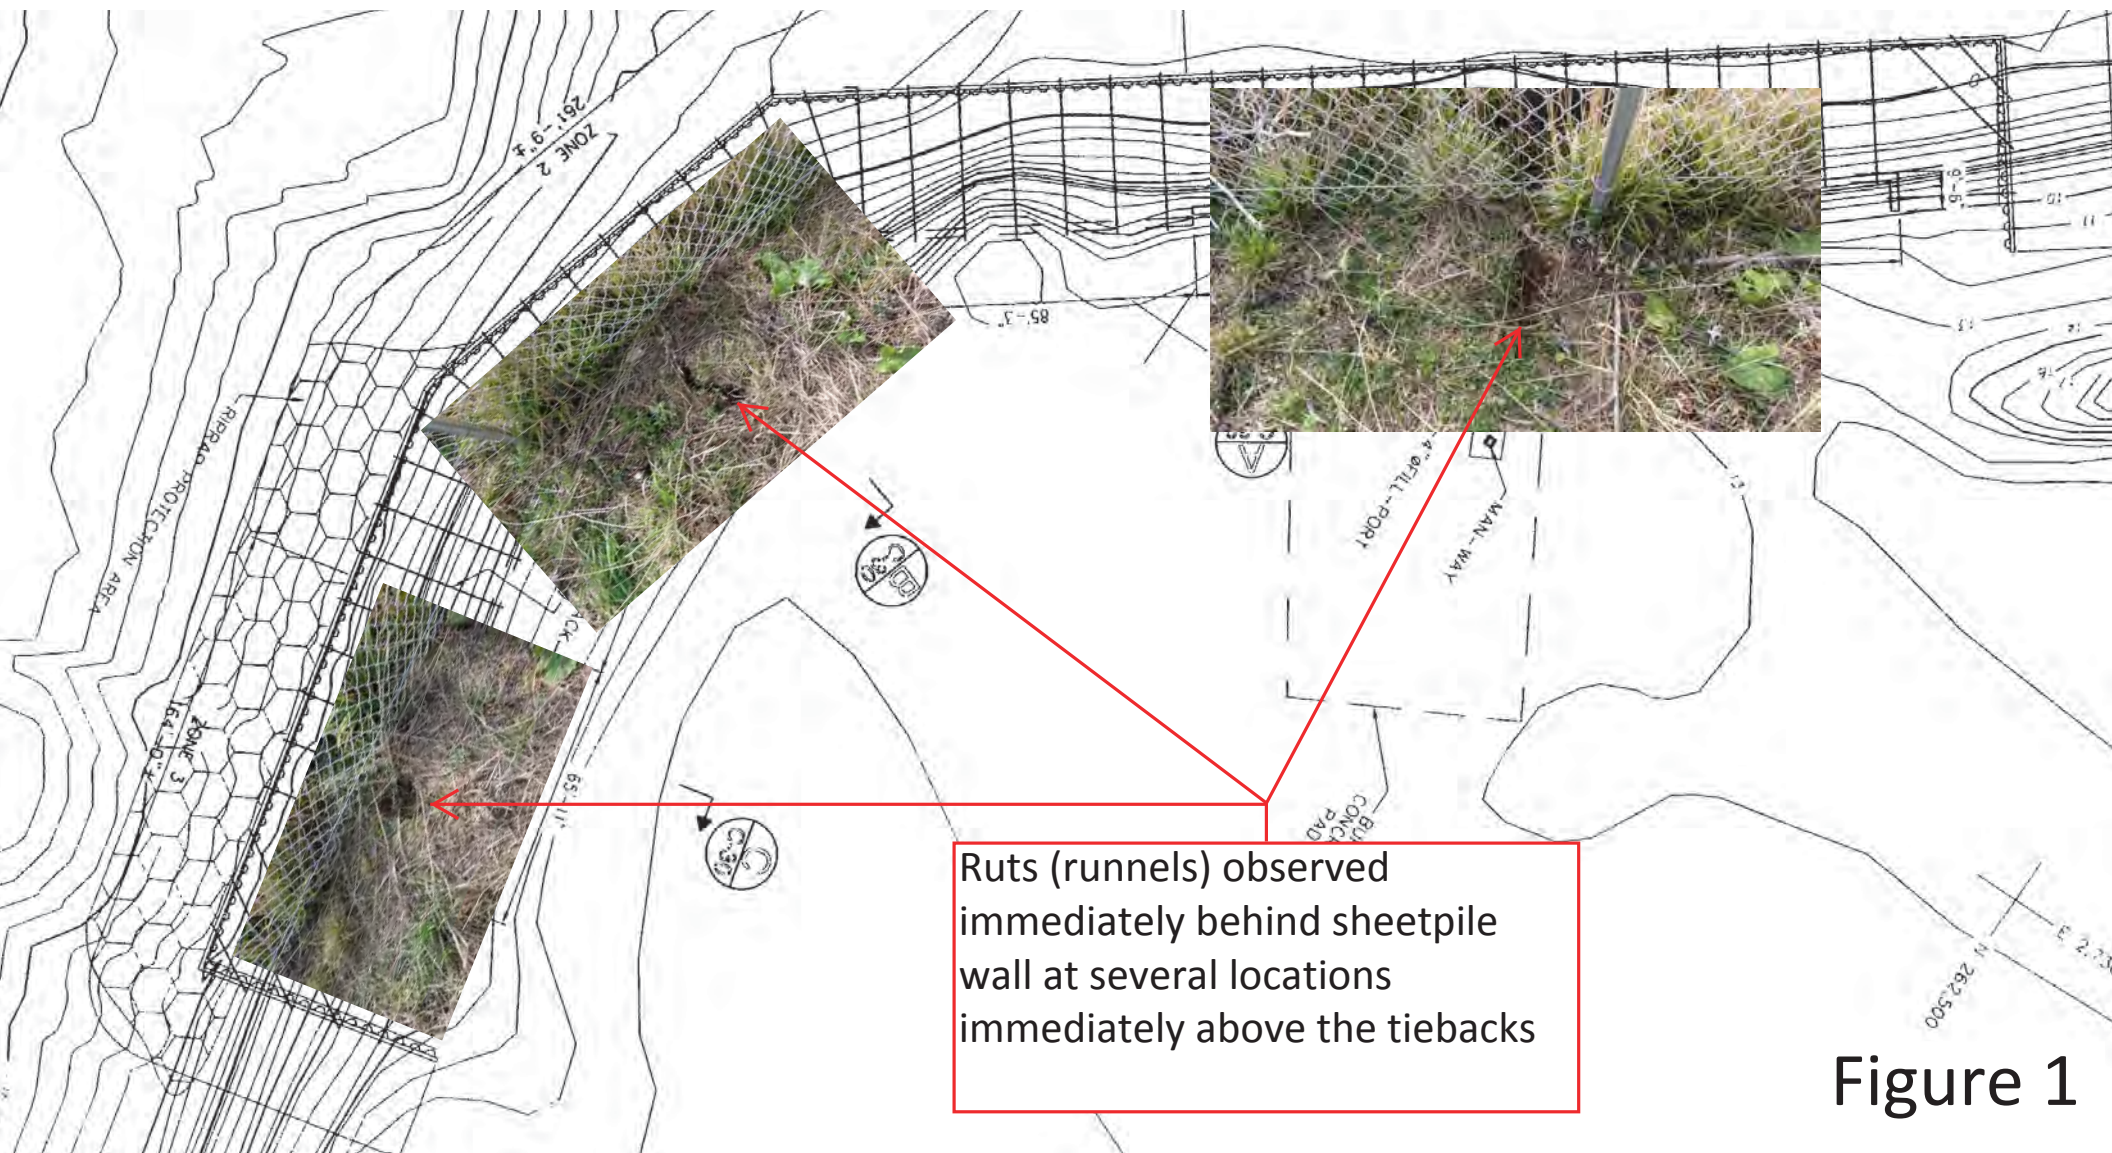


Figure 1

Movement of support
relative to wale



Bowing of wale

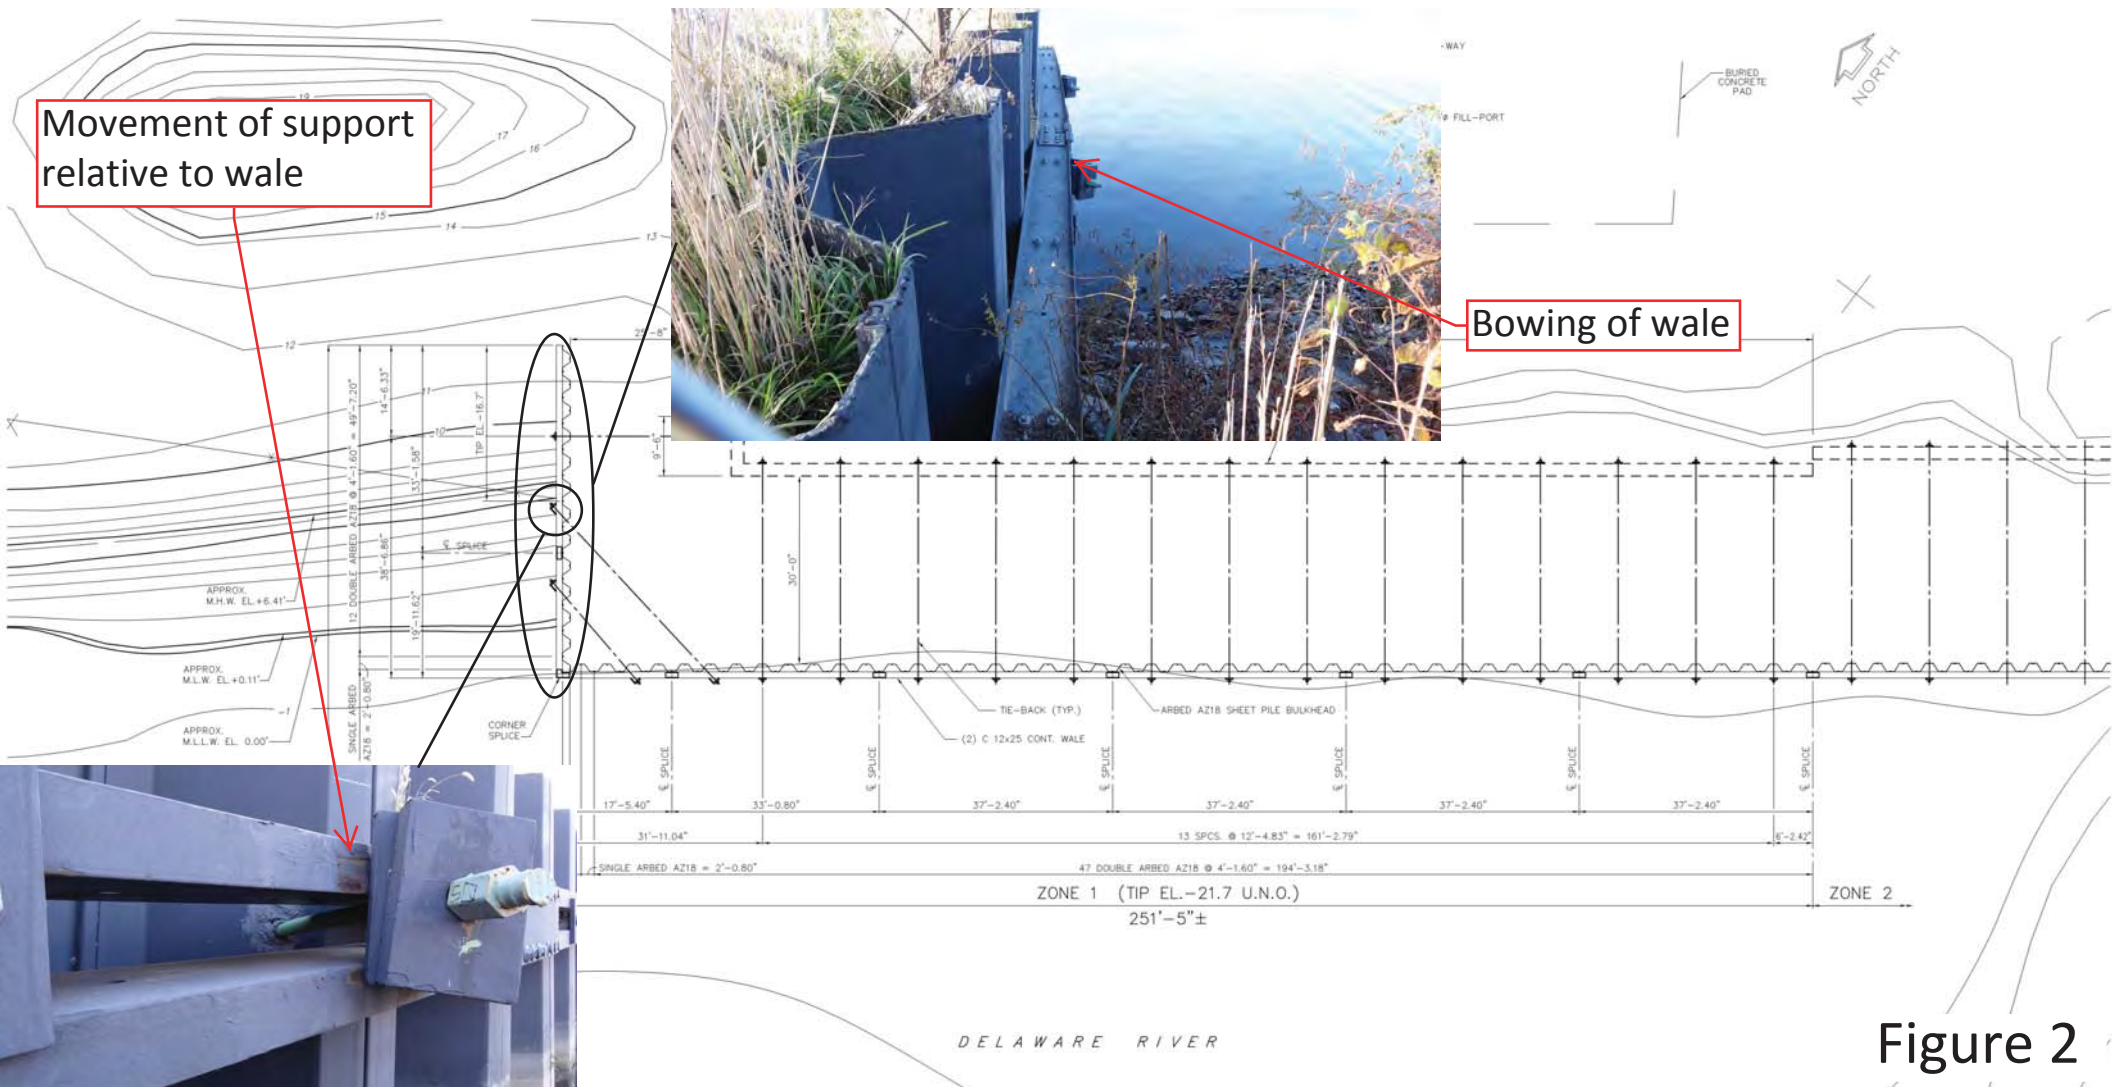


Figure 2

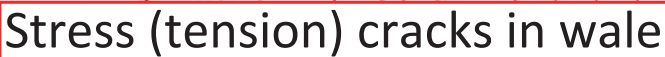
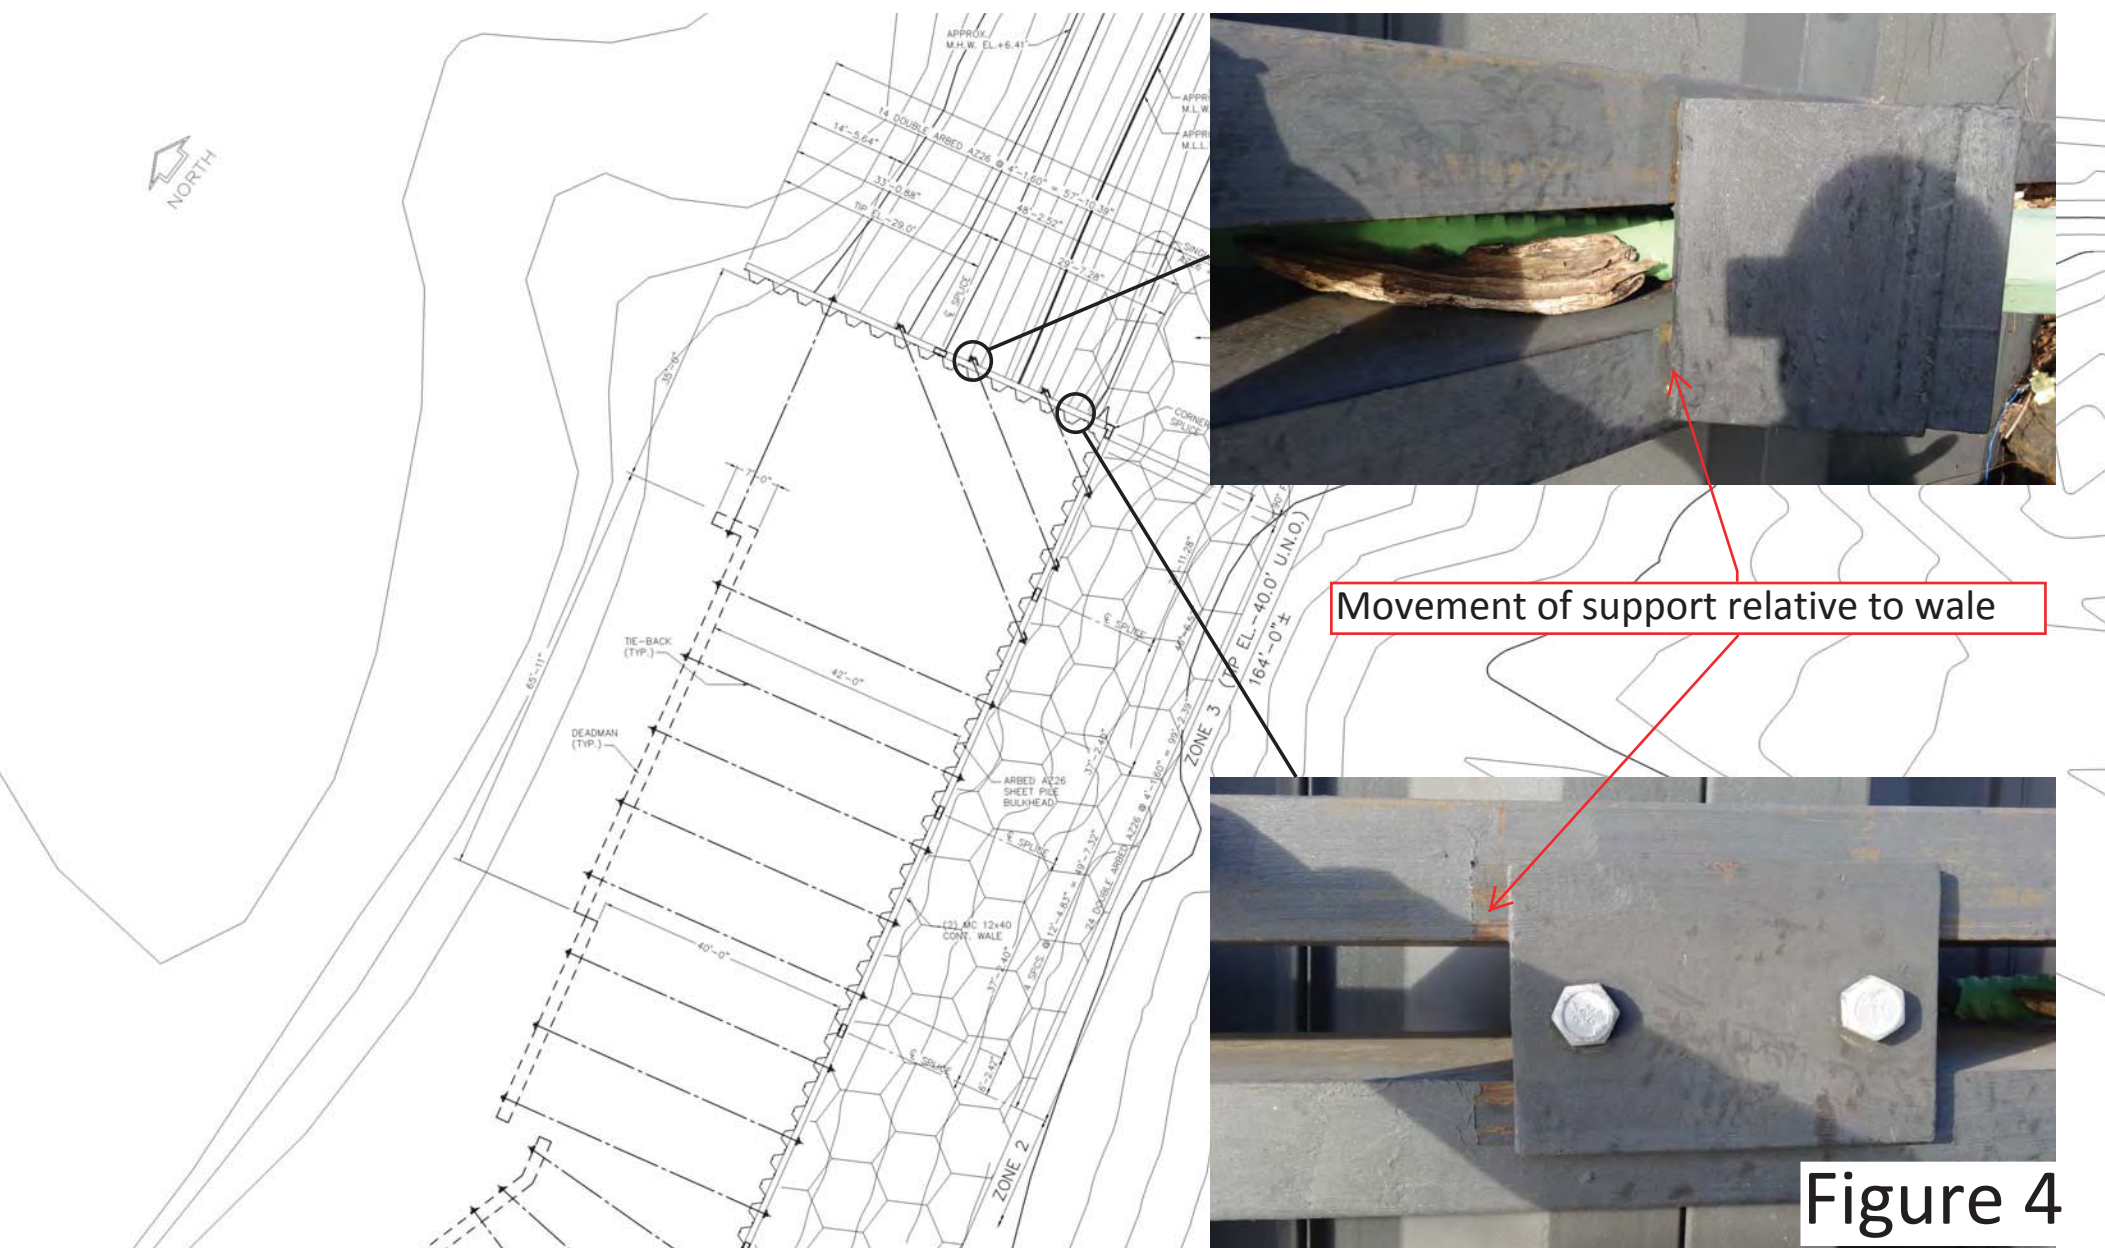


Figure 3



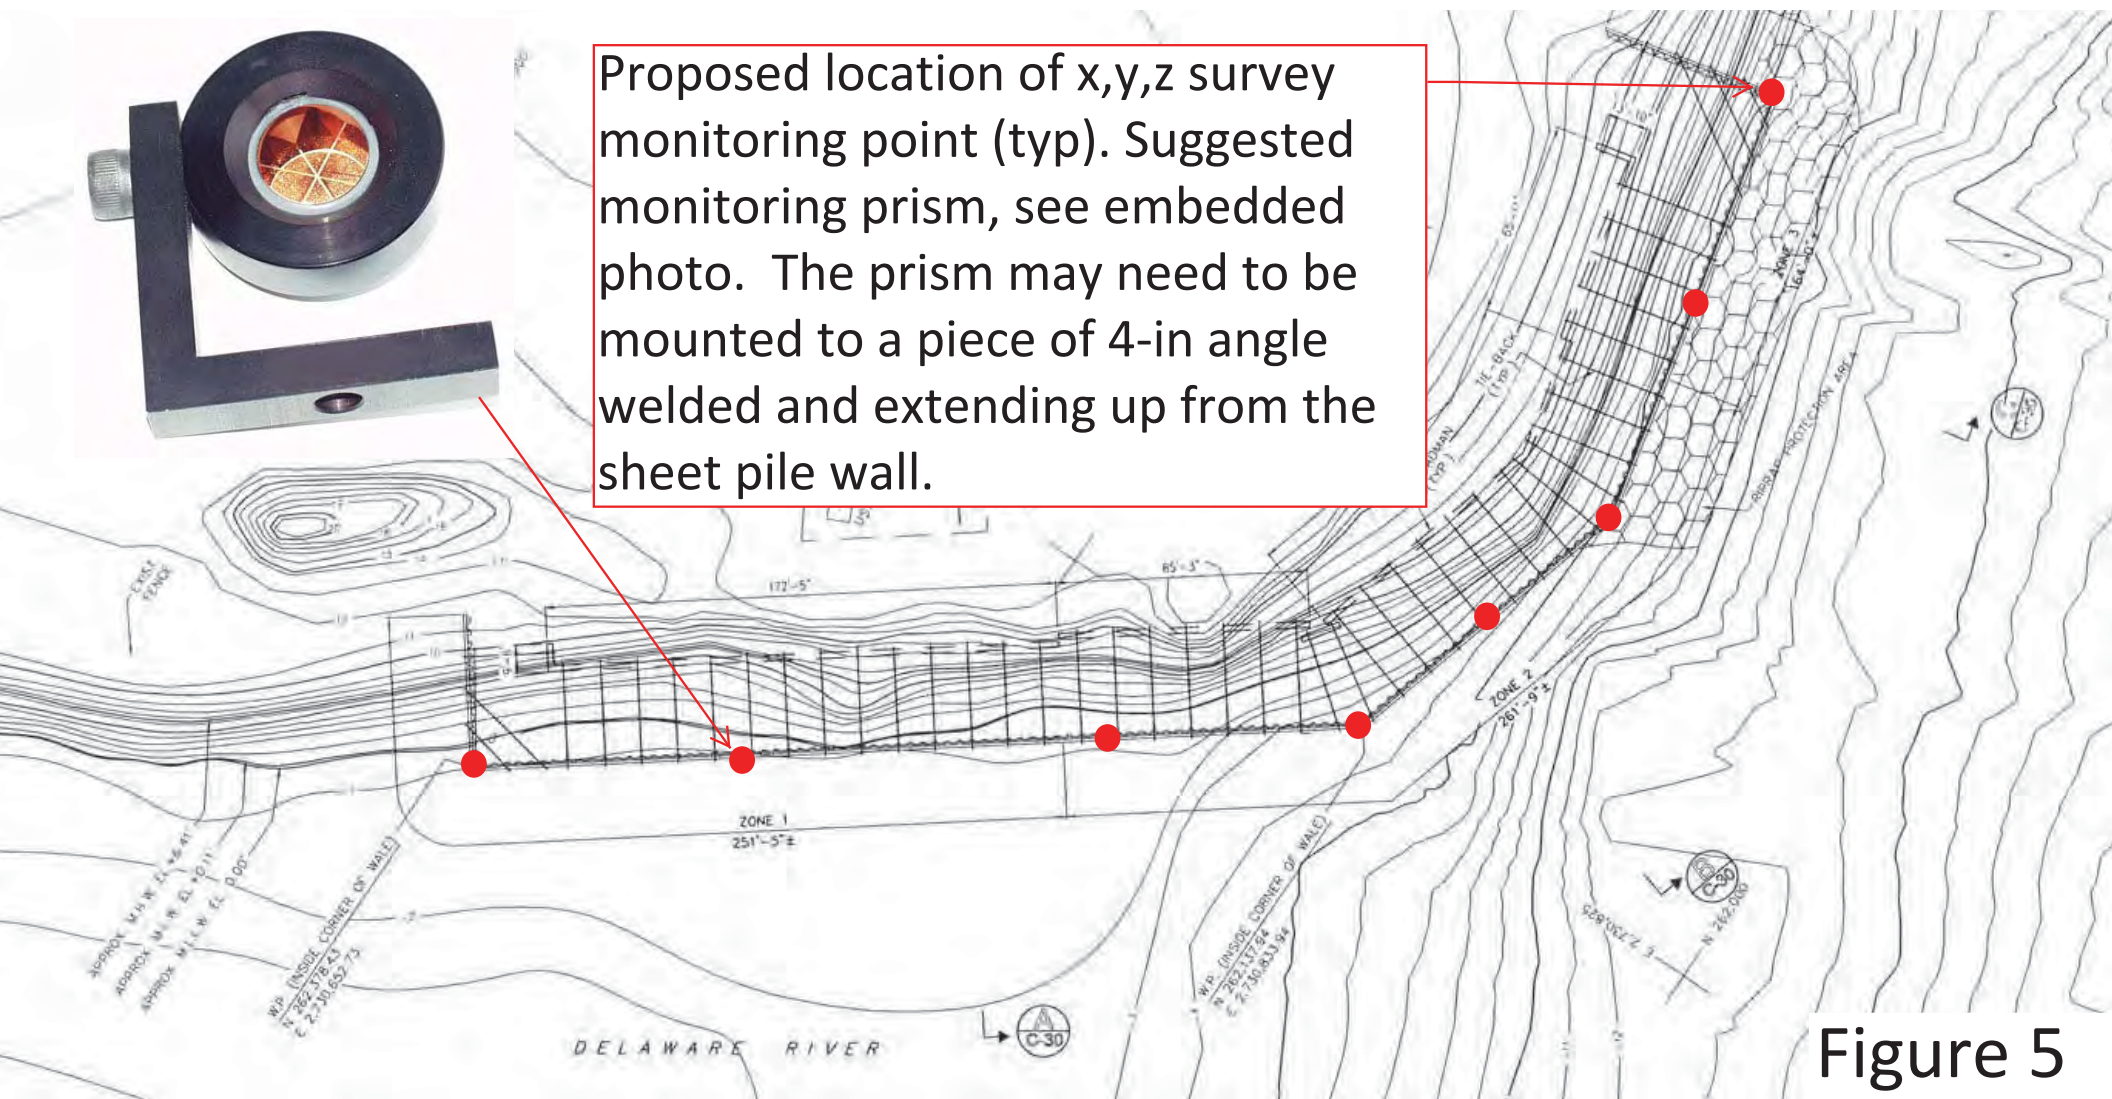


Figure 5


APPENDIX A


REFERENCE PLANS

1. PLANS ENTITLED "UNITED STATES ENVIRONMENTAL PROTECTION AGENCY REGION 3, REVISED REMEDIAL DESIGN, METAL BANK NPL SITE, PHILADELPHIA, PENNSYLVANIA" SHEETS 1 THRU 49, PREPARED BY: AMEC EARTH & ENVIRONMENTAL, INC., PLYMOUTH MEETING, PA; 11/09/2007 & 4/04/2008.
2. PLAN ENTITLED "HYDROGRAPHIC SURVEY, METAL BANK NPL SITE, PRE-EXCAVATION SURVEY, SITUATED IN CITY OF PHILADELPHIA, PHILADELPHIA COUNTY, PENNSYLVANIA", PREPARED BY: LGA ENGINEERING, INC., LAKEWOOD, NJ; DATED: 9/08/2008.

GENERAL NOTES

PROJECT COORDINATE SYSTEM:
HORIZONTAL: PENNSYLVANIA STATE PLANE COORDINATE SYSTEM (SPCS), PA SOUTH ZONE,
NORTH AMERICAN DATUM (NAD) 83/92.
VERTICAL: NORTH AMERICAN VERTICAL DATUM 1988 (NAVD 88)

- 
 SITE BENCHMARK: MAG NAIL IN UTILITY POLE (NO #)
 ELEVATION: 12.07'
 DATUM: NAVD 88

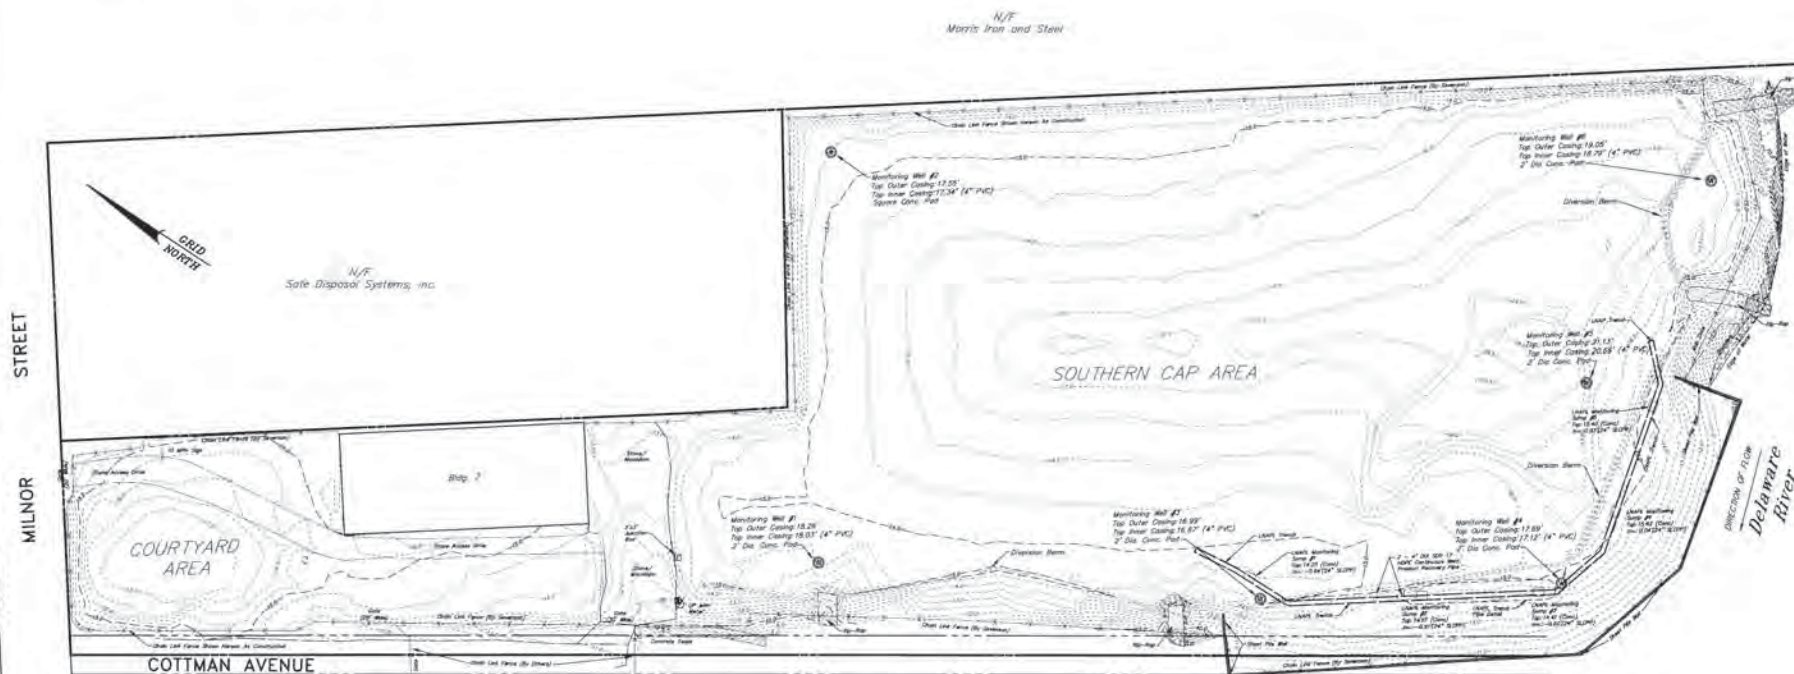

CERTIFICATION STATEMENT

BY THIS SUBMITTAL, I HEREBY REPRESENT THAT I HAVE DETERMINED AND VERIFIED THE CONTOURS OF THE SOUTHERN CAP AREA AND THE COURTYARD AREA SHOWN HEREON AS OF JANUARY 19, 2010.

DAVID L. JENSEN, PLS NO. SU075123, FOR RETTEW ASSOCIATES, INC.

TOPOGRAPHIC SURVEY
FINAL CONTOUR AS-BUILT
AS OF JANUARY 19, 2010

REVIEW
 RETIREW ASSOCIATES, INC.
 22223 Windgate Drive, Chester Springs, PA 19425
 Phone (610) 456-7000 • Fax (610) 456-3273
 e-mail: retirew@retirew.com

Sevenson Environmental Services, Inc.
2749 Lockport Road
Niagara Falls, NY 14305

MANAGER:	DESIGN BY:	FURNITURE:	DRAWN BY:
DLJ		SURV. CHIEF: MBS	

SEAL OF THE COMMONWEALTH OF MASSACHUSETTS

1	REVISED LABEL CONTAINERS & DIVISIONS ITEM
2	REVISED TRENCH LABEL/TEXT COLOR
3	REVISED AND PHOSPHORY LIME SAFE DISPOSAL
4	REVISED TRENCH EXT. LABEL

Memo

To **Joseph Vitale (MPI)**
From **Don Dotson**
Tel **615-333-0630**
Fax **615-781-0655**
Date **September 5, 2008**

File no **470530001.0300.******
cc

Subject Site Visit, Driving Criteria, Wall Surcharge, Pile Tip Elevation, & Obstructions

Site Visit

I visited the site on August 28, 2008 to observe the condition of the sheet piles driven to-date at Zone 3. As indicated by the photos below, some of the piles were visibly out-of-plumb both to the east (Photo 1) and north (Photo 2).



Photo 1



Photo 2

In addition, some of the pile tops were visibly damaged (Photo 3).



Photo 3

It appears that the piles were refusing on the underlying weathered schist above the design tip elevation of -40.0 feet and additional energy was applied in an attempt to reach -40.0 feet. This is a likely cause of the out-of-plumbness.

Driving Criteria

AMEC recommends that the following driving criteria from the Corps of Engineers EM 1110-2-2504 be adopted and the following text added before the first sentence of Project Specification Section 3.02.A. Pile Driving: "Drive the piles with a vibratory hammer with a minimum of 2200 inch-pounds of energy to the indicated tip elevation or refusal, whichever occurs first. Refusal is defined as the point where the penetration rate falls below one foot per minute."

Surcharge

The current sheet pile wall design includes a surcharge amount of 150 psf. This was included in anticipation of the requirement for construction equipment to be within close proximity to the top of the wall during excavation operations. After reviewing the sheet pile wall design calculations, AMEC does not believe that it would be prudent to remove the surcharge criteria at this time. Since it is likely that some redesign of the sheet pile wall will be required due to the final sheet pile tip elevation, AMEC can review the surcharge criteria at that time.

Pile Tip Elevation for Remedial Construction

Based upon AMEC's groundwater elevation memo and scour analysis memo the pile tip elevations required will be based upon the scour analysis results. The controlling groundwater elevation pertaining to the secondary function of the sheet pile wall is -5 feet elevation. The controlling scour depths for the primary function of the sheet pile wall are 22 feet of sheet pile embedment length in Zone 3 and 10 feet of sheet pile embedment length in both Zones 1 and 2.

Sheet Pile Obstructions

If piles refuse on an obstruction above the minimum required depth for scour, the sheet piles should be removed and the obstruction removed or penetrated with a chisel beam. The sheet pile should then be re-driven to the design tip elevation or to refusal, whichever occurs first.

Don W. Dotson, PE, SE, P. Eng., PhD
Senior Engineer, Chief Designer
Geo-Structural Design Group

1. THE PURPOSE OF THESE NOTES IS TO INDICATE THE MINIMUM REQUIREMENTS OF MATERIALS TO BE FURNISHED AND INSTALLED UNDER THE CONTRACT TO BE USED FOR FUTURE REFERENCE BY THE CLIENT, ITS HEIRS, AND/OR SUCCESSORS. THESE NOTES, OR PORTIONS THEREOF, SHALL NOT BE USED BY THE CONTRACTOR IN PLACE OF PROJECT SPECIFICATIONS.

3. THE COMPLETED BULKHEAD HAS BEEN DESIGNED TO WITHSTAND A 150 PSF SURCHARGE IN CONJUNCTION WITH DESIGN BRIDGE MODULI. ELEVATIONS INDICATED IN THE CONTRACT DRAWINGS. THE BULKHEAD HAS BEEN DESIGNED WITH THE INFORMATION PROVIDED IN THE SOIL BORING LOGS PROVIDED IN THE BID DOCUMENT.

5. SUBSTITUTIONS MAY BE FURNISHED FOR MATERIALS SPECIFIED HEREIN PROVIDED ACCEPTANCE IS SECURED BY THE ENGINEER.

6. STRUCTURAL FILL FINEST THE SWEET PILE WALL SHALL CONSIST OF UNWORN OR CRUSHED STONE BANK OR CRUSHED GRAVEL OR MATHER'S BEDDED OPEN OR CRUSHED STONE SHALL CONSIST OF WELL GRADED, ROUND, TIGHT, DURABLE STONE BANK OR CRUSHED GRAVEL SHALL CONSIST OF WELL GRADED, ROUND, TIGHT, DURABLE PARTICLES OF CRUSHED OR UNCRUSHED GRAVEL FREE FROM SOFT, THIN, ELONGATED OR LAMINATED PIECES AND BRANING OF OTHER MATERIALS. THE FINES CANNOT PASS THROUGH (NO. 20) STANDARD SIEVE. THIS MATERIAL SHALL NOT EXCEED 15% TO INSURE THE BACKFILL IS FREE DRAINING.

WELDING SHALL CONFORM TO THE STRUCTURAL WELDING CODE FOR STEEL (LATEST EDITION, AS ADOPTED BY THE AMERICAN WELDING SOCIETY (AWS)). WELDING SHALL BE PERFORMED BY A WELDER CERTIFIED IN ACCORDANCE WITH AWS STANDARDS.

8. FURTOP FARMING SHALL BE IMPROVED TOOK CLOTHES FREE FARMING

7. CONCRETE WORK SHALL CONFORM TO THE REQUIREMENTS OF ACI 318-LATEST EDITION BUILDING CODE REQUIREMENTS FOR REINFORCED CONCRETE AS ADOPTED BY THE AMERICAN CONCRETE INSTITUTE.

10) DETAILING, FABRICATION, AND ERECTION OF REINFORCING STEEL SHALL CONFORM TO THE REQUIREMENTS OF ACI-318 AND THE ACI MANUAL OF STANDARD PRACTICE FOR DETAILING REINFORCED CONCRETE STRUCTURES.

11. DETAILING, FABRICATION, AND ERECTION OF REINFORCING STEEL SHALL CONFORM TO THE REQUIREMENTS OF ACI-318 AND THE ACI MANUAL OF STANDARD PRACTICE FOR DETAILING REINFORCED CONCRETE STRUCTURES.

(2) DESIGN, FABRICATION AND ERECTION OF STRUCTURAL STEEL SHALL CONFORM TO THE MANUAL OF STEEL CONSTRUCTION - ASD, NINTH EDITION AS DESCRIBED BY THE AMERICAN INSTITUTE OF STEEL CONSTRUCTION.


13. SYSTEMS INTERNATIONAL, USA, INC. 100 LINDEN ST. (BAY) LA JOLLA, CALIF. 92037
E-100 SERIES, AS REQUIRED FOR CONTINUOUS OR INTERMITTENT USE

44. THE ROD ASSEMBLIES CONSISTING OF THE ROD, STIFF COUPLERS, AND EYES, SHALL BE DYWIDAG THREADBAR REINFORCING SYSTEM AS MANUFACTURED BY DYWIDAG.

10-ASTM A615 (EXCEPT FOR MARKINGS). THE ROD ASSEMBLIES SHALL BE FUSION BONDED EPOXY COATED. FUSION BONDED EPOXY COATING SHALL CONFORM TO ASTM A75.

15. CONNECTIONS SHALL BE DESIGNED AND DETAILED BY THE STEEL FABRICATOR EXCEPT FOR THOSE SPECIFICALLY DETAILED BY THE CONTRACT DOCUMENTS.

SECTION 10

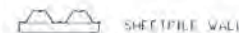

1. FOR SHEETING WALL SECTION, AND DETAILS SEE DRAWING NOS. C-27 THRU C-31. AT THE DISCRETION OF THE ENGINEER, ACTUAL EMBEDMENT DEPTHS MAY VARY DUE TO ENCOUNTERED CONDITIONS IN THE FIELD AT THE TIME OF INSTALLATION.

2. ELEVATIONS ARE IN FEET AND REFERENCE THE MEAN LOWER LOW WATER DATUM. HORIZONTAL COORDINATES REFERENCE NORTH.

LAND SURVEY DATA ARE BASED ON SURVEY BY AMERICAN
GEOTECH, INC. DATED NOVEMBER 24, 1999

8. BATHYMETRIC SURVEY DATA ARE BASED UPON SURVEY BY AQUA SURVEY, INC. PROVIDED TO AMERICAN OCEANIC INC.

1. SECTIONS AND DETAILS APPLY TO SAME AND SIMILAR CONDITIONS UNLESS SPECIFICALLY NOTED OTHERWISE.

3. PATHWAYS ARE VARIABLE AND SUBJECT TO CHANGE

2. SUBMERGED OBJECTS MAY BE PRESENT IN THE PROJECT AREA

3. UNSPACED UPLAND EXCAVATIONS SHALL BE CONDUCTED A MINIMUM OF 15 FEET SHOREWARD FROM THE CONCRETE BEACHMEN. IN THE EVENT THAT THIS DISTANCE IS UNACHIEVABLE, SHORING MUST BE CONSTRUCTED AND APPROVED BY THE ENGINEER.

NOTE: DUE TO POTENTIAL EXPANDED EXCAVATION, CONTRACTOR MUST INSTALL EROSION CONTROL PRIOR TO EXCAVATION. THEN, PROTECT WALL DURING EXCAVATION AND INSTALL DEADMEN ANCHORS ONCE EXCAVATION IS COMPLETED.


TRUE NORTH
GRAPHIC SCALE



NO.	DATE	REVISIONS	APPR.	NO.	DATE	REVISIONS	APPR.
1	03/01/00	30% Design Submittal		6			
2	02/02/01	60% Design Submittal		7			
3	03/14/02	90% Design Submittal		8			
4	09/06/02	100% Design Submittal		9			
5				10			



amec EARTH & ENVIRONMENTAL, INC.
ONE PLYMOUTH MEETING, SUITE 850
PLYMOUTH MEETING, PENNSYLVANIA 19462

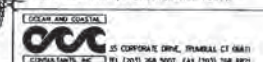

PREPARED FOR: COTTMAN AVENUE PRP GROUP

SUBMITTED TO: UNITED STATES ENVIRONMENTAL PROTECTION AGENCY

REGION III
1650 ARCH STREET
PHILADELPHIA, PENNSYLVANIA

CONTACT: MS. LINDA R. DIETZ


1. The first step in the process is to identify the problem or issue that needs to be addressed. This involves gathering information and understanding the context of the problem.


407	REMEDIAL DESIGN METAL BANK NPL SITE PHILADELPHIA, PENNSYLVANIA
-----	--


TITLE SHEETPILE WALL GENERAL PLAN & NOTES



DESIGN BY	CM	CHECKED BY	RS	DATE	09/05/02
SCALE	AS SHOWN	NO. OF	24	SHEET	25 OF 25

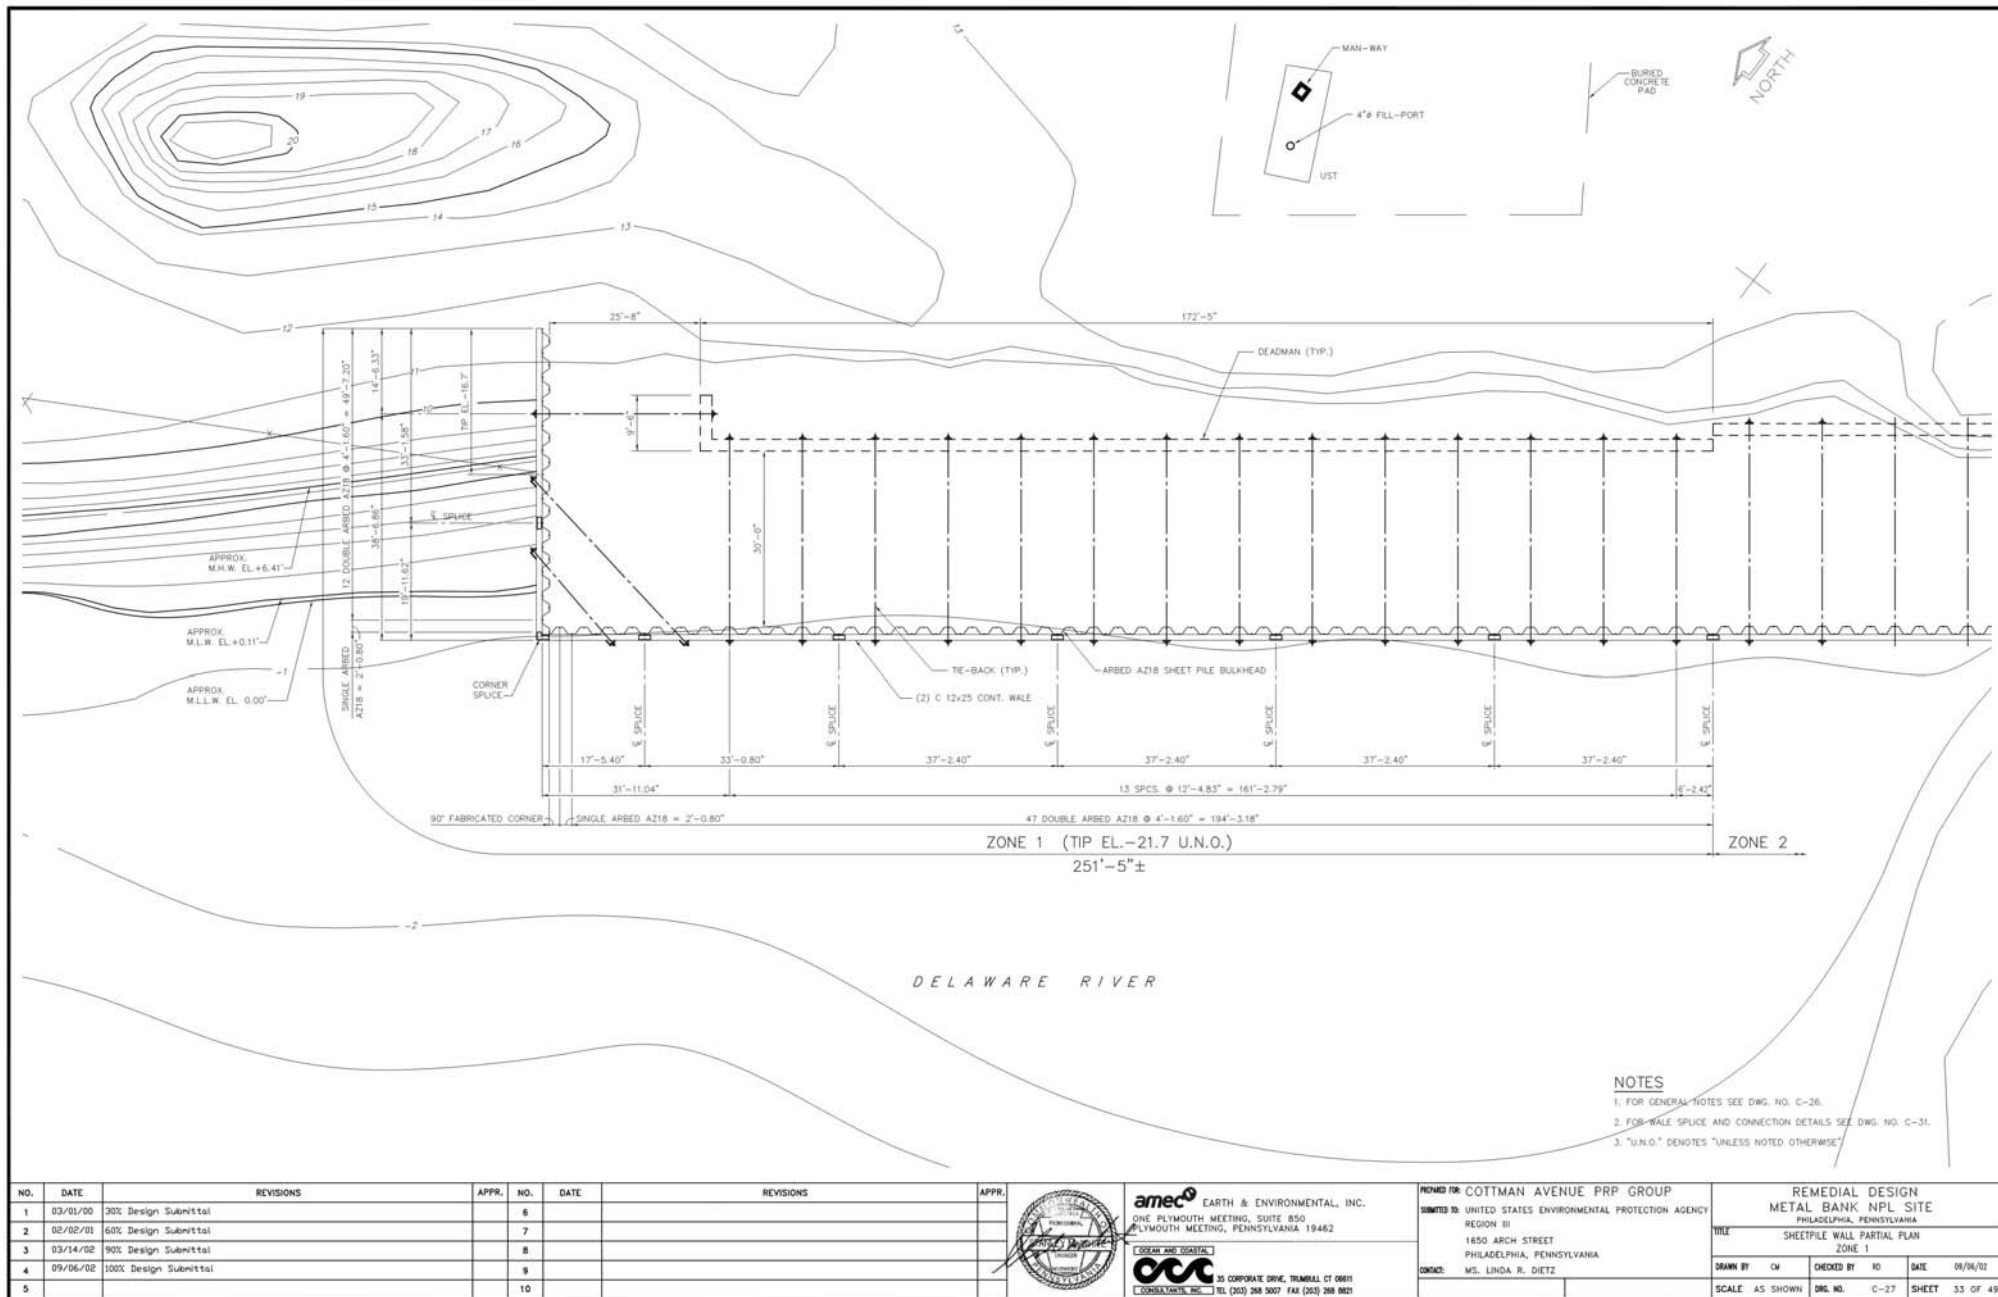SCALE	AS SHOWN	REV	NO	C-26	SHEET	32 OF 32
-------	----------	-----	----	------	-------	----------

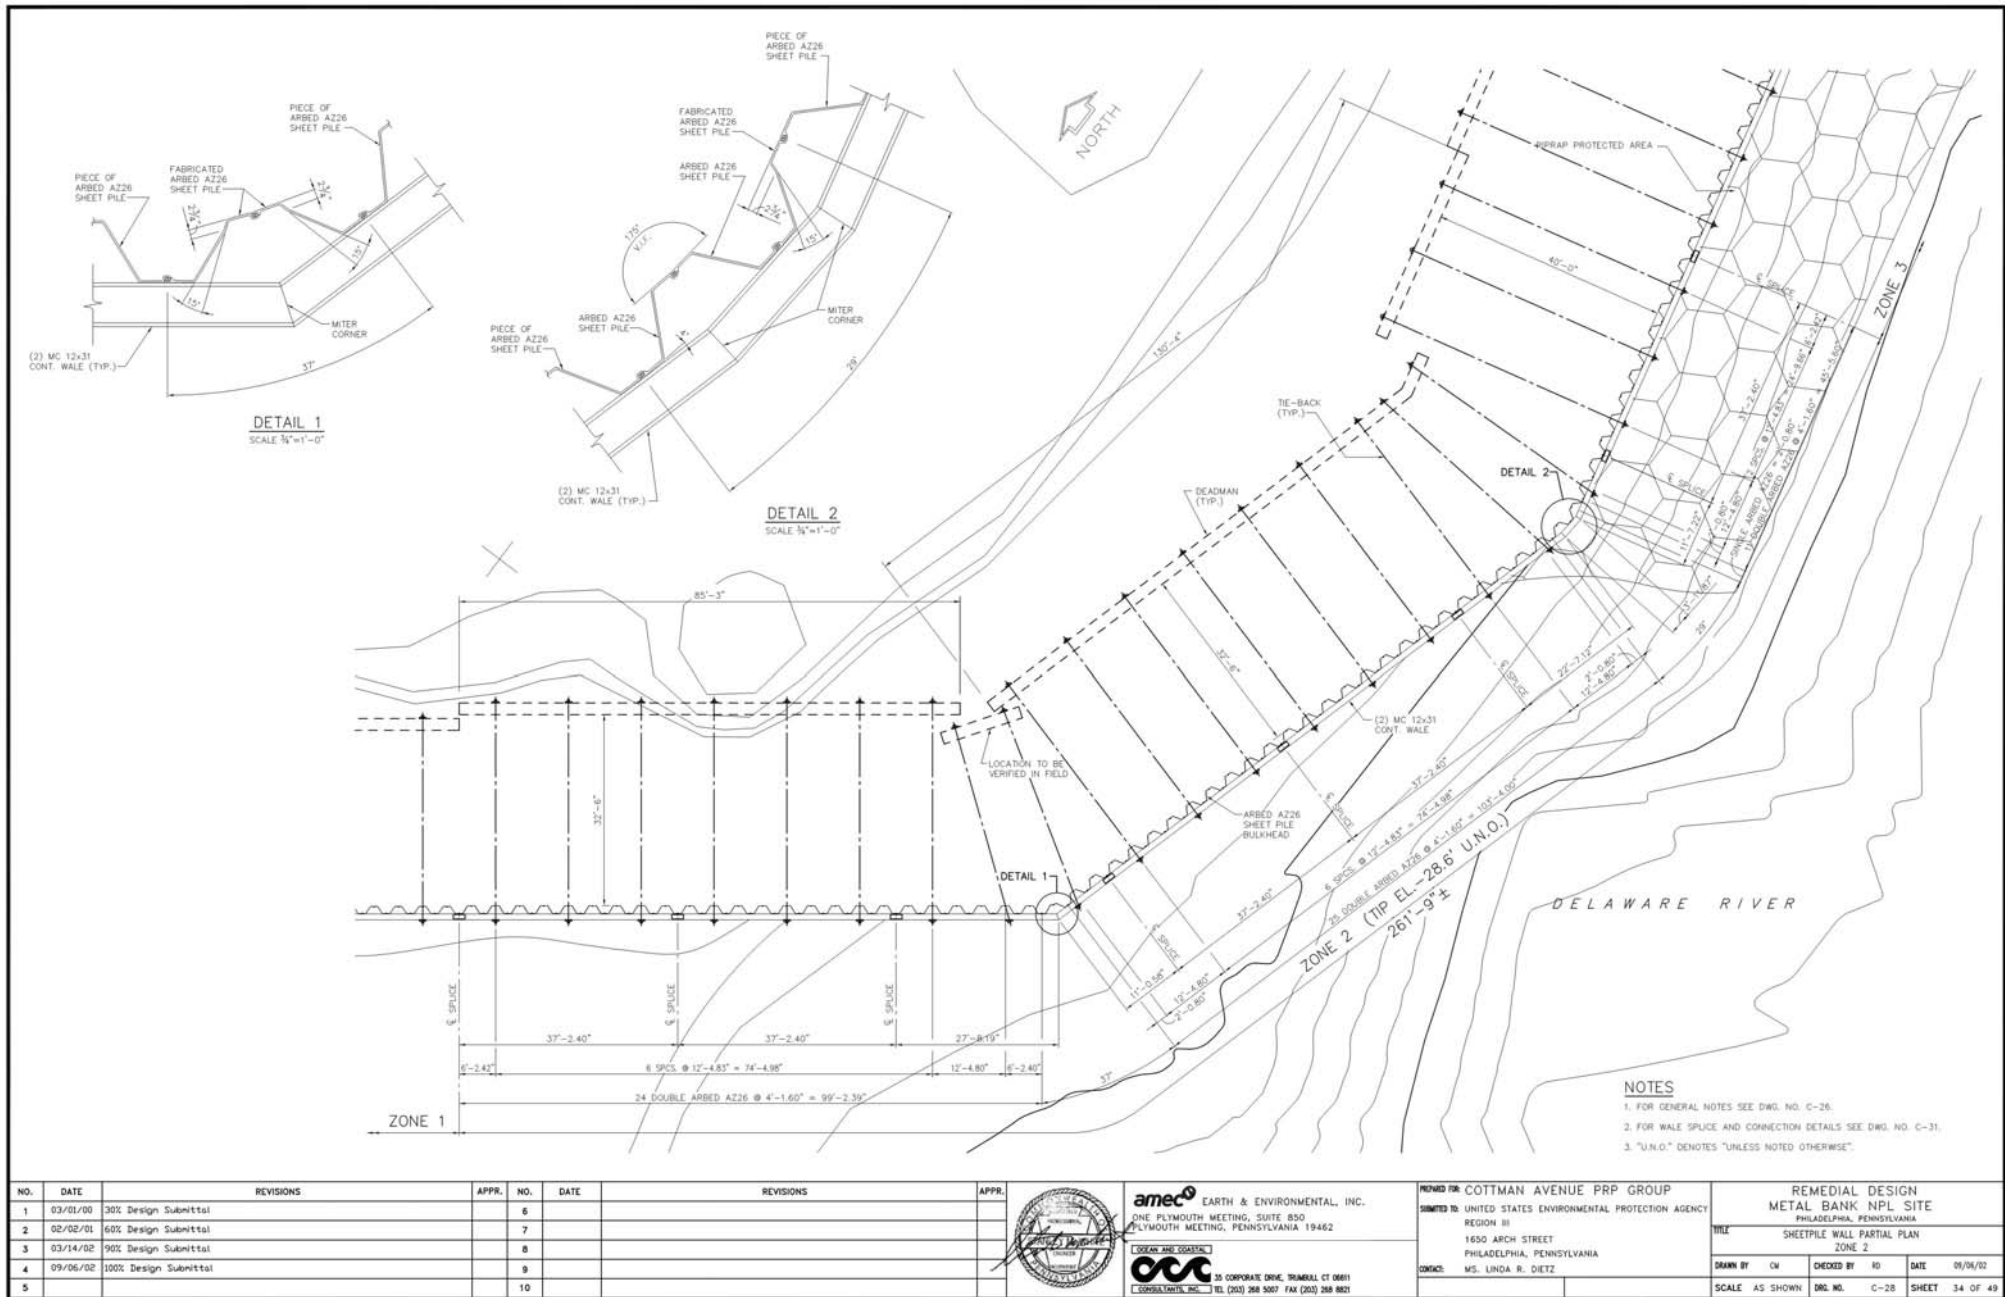

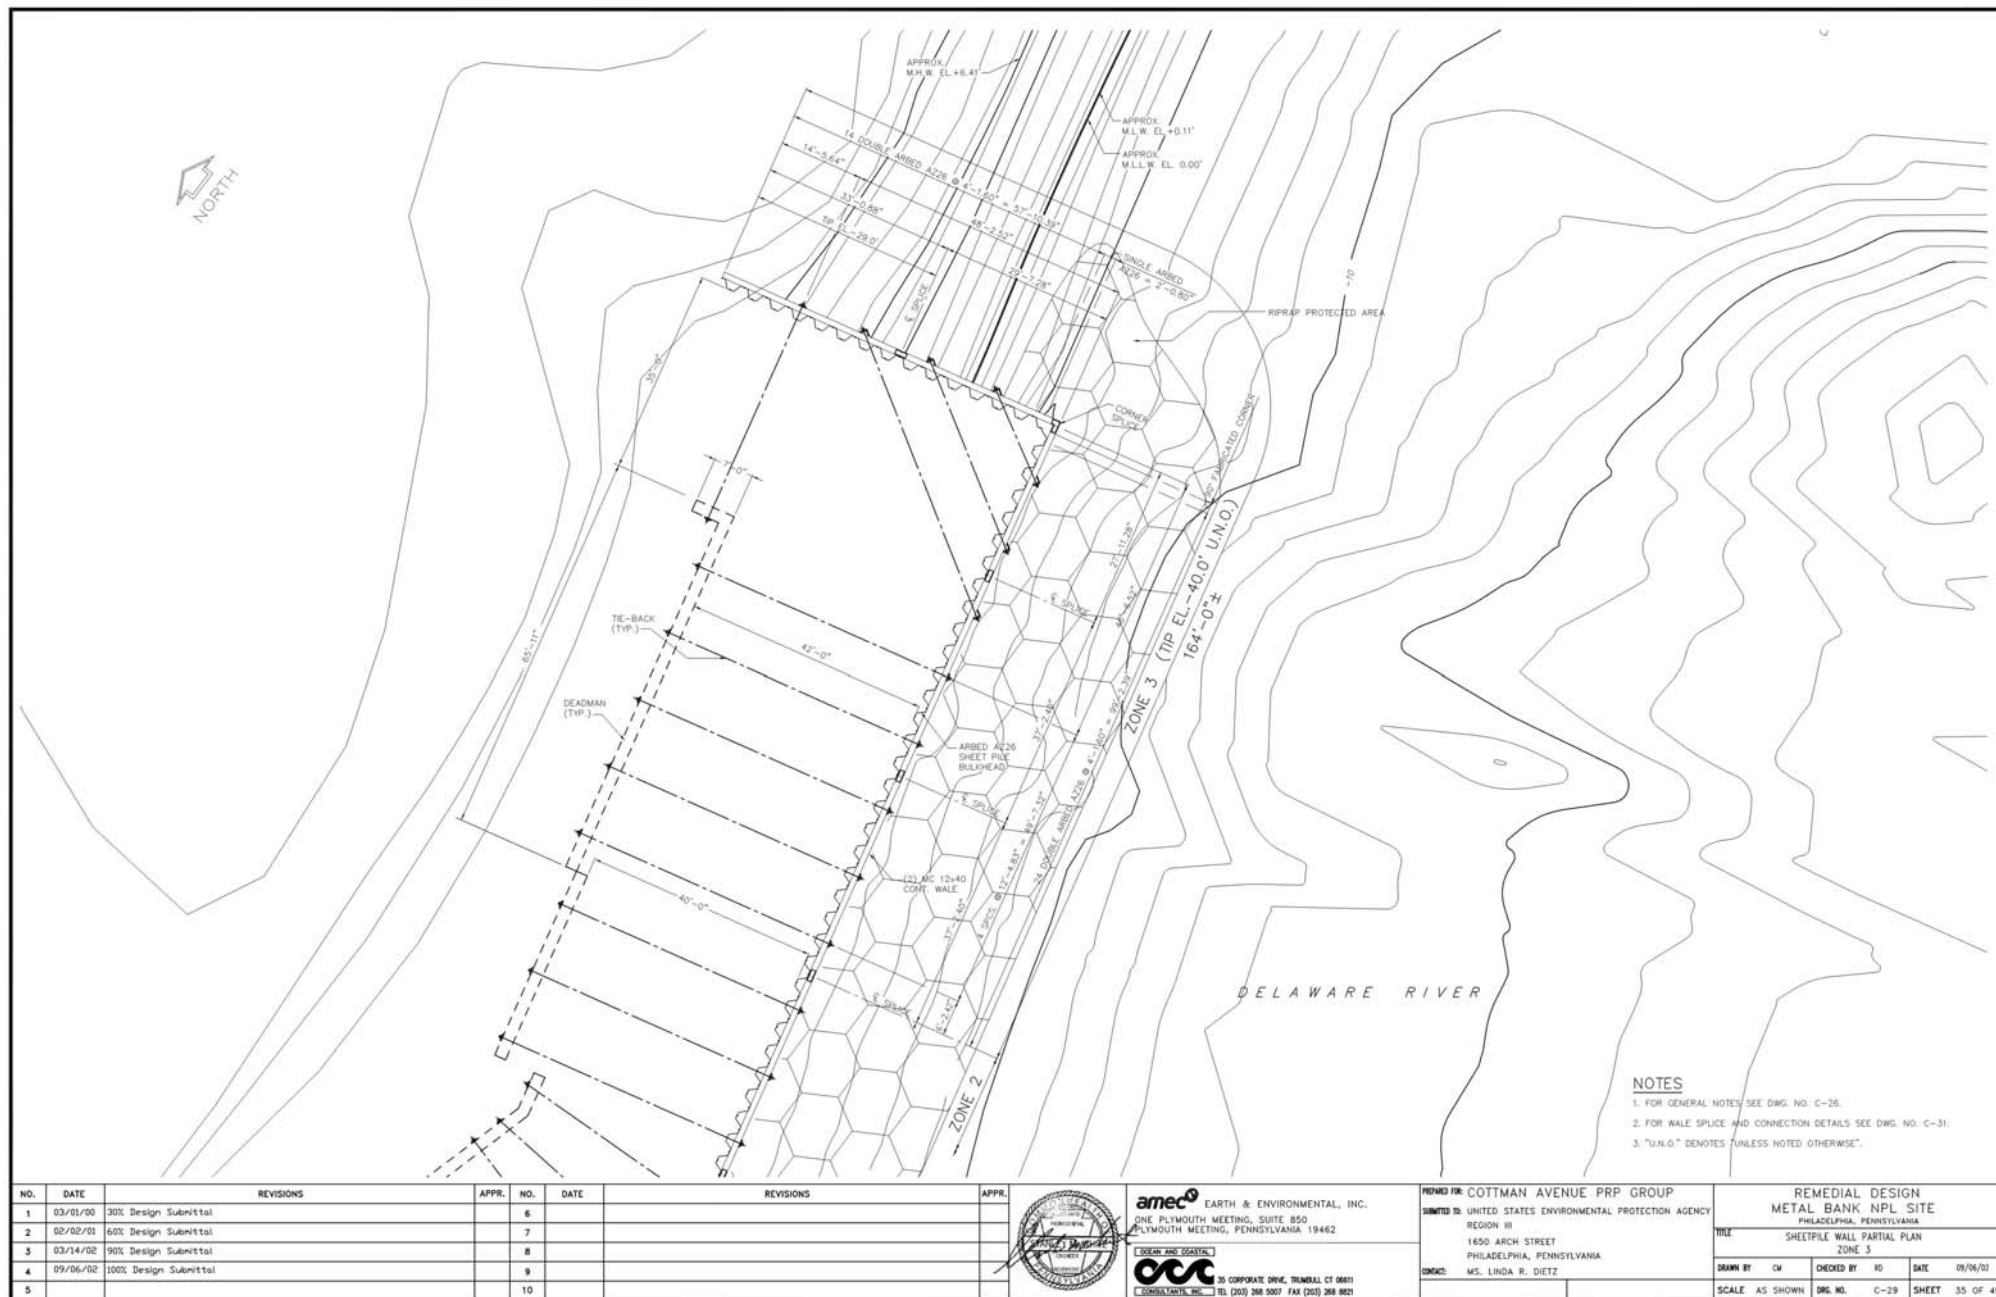



NO.	DATE	REVISIONS	APPR. NO.	DATE	REVISIONS	APPR.	 ameco EARTH & ENVIRONMENTAL, INC. ONE PLYMOUTH MEETING, SUITE 850 PLYMOUTH MEETING, PENNSYLVANIA 19462 DESIGN AND CONSULTANTS  35 CORPORATE DRIVE, THUMBALL CT 06011 CONSUMERS, INC. TEL (203) 268 5007 FAX (203) 268 8021	PREPARED FOR: COTTMAN AVENUE PRP GROUP	REMEDIAL DESIGN METAL BANK NPL SITE PHILADELPHIA, PENNSYLVANIA			
1	03/01/00	30% Design Submittal		6				SUBMITTED TO: UNITED STATES ENVIRONMENTAL PROTECTION AGENCY	REGION III			
2	02/02/01	60% Design Submittal		7				1650 ARCH STREET	TITLE: SHEETPILE WALL PARTIAL PLAN ZONE 3			
3	03/14/02	90% Design Submittal		8				PHILADELPHIA, PENNSYLVANIA	DRAWN BY: GW			
4	09/06/02	100% Design Submittal		9				CONTOUR: MS. LINDA R. DIETZ	CHECKED BY: KO			
5				10					DATE: 09/06/02			
								SCALE: AS SHOWN				
								DRG. NO.: C-29				
								SHEET: 35 OF 41				

APPENDIX B



RA Consultants LLC

47 Wilkens Drive, Dumont, New Jersey 07628

Project No: 12C1135

Client: Environ

Project: Metal Bank

Sheet No: 1

Date: 5-4-13

Subject: Wale - corner repair

Des. By: WSP


(E) - EXISTING

(N) - NEW

(E) MC 12 X 31 WALE
TOP and BOTTOM

(E) FABRICATED A226
SHEETPILE

(N) 1-1/2" PLATE
PLACE WITHIN FLANGE (TOP)
PLACE ON TOP WEB (BOT)

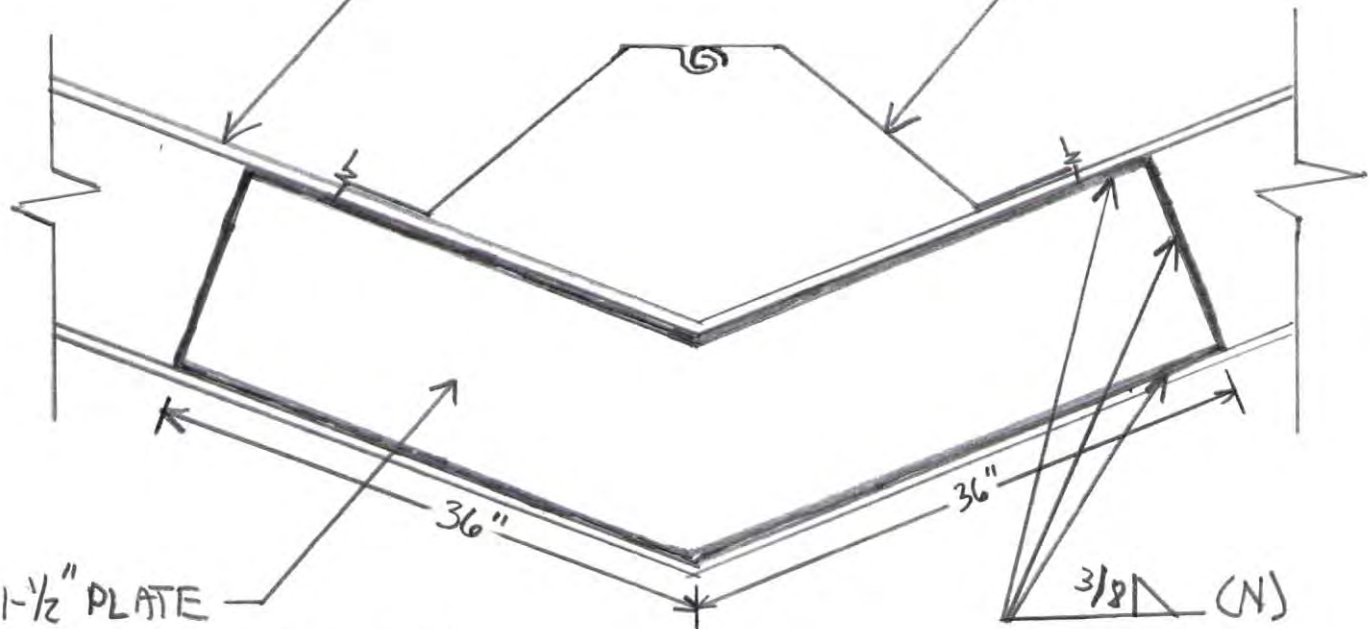

DETAIL 1

PART PLAN - INTERSECTION OF
ZONE 1 & ZONE 2.

UTS